

11-7-90

AR

10-22-90

217-90

The undersigned hereby applies for permission to make certain improvements as described below. (Plans to be submitted if required by Zoning Administrator.) All construction to be completed in accordance with Zoning Laws and Building Regulations of the Town of Essex and the State of Vermont, and conform to the National Board of Fire Underwriters' Regulations and any and all Federal Regulations now in effect.

A PROPERTY ADDRESS 4 Catella Rd., Essex, VT OWNER NAME Mark Robert Hunziker

OWNER ADDRESS P.O. Box 601, Essex Jct., VT PHONE NUMBER - WORK 878-0477 HOME 878-0477

TOWN TAX MAP 15 PARCEL 24-1 PLAN FILED LAND RECORDS BOOK _____ PAGE _____ ESTIMATED COST \$80,000.

B SEWAGE DISPOSAL PUBLIC CONNECTION FEE _____ DATE PAID _____

PRIVATE PLAN ATTACHED APPROVED REJECTED

BY Mary Clark / Site Tech DATE 10-3-90

ON SITE INSPECTION BY _____ DATE _____

AS BUILT SUBMITTED NO. OF BEDROOMS 3

C WATER PUBLIC FEE _____ DATE PAID _____

NO. OF METERS _____ REQUEST DATE _____

PRIVATE APPROVED BY existing

D HIGHWAY R.O.W. SEWER WATER POWER TEL GAS TV POLE PERMIT

APPROVED BY _____ DATE _____

E DRIVE CURB CUT APPROVED BY existing DATE _____

CULVERT REQUIRED X TYPE _____ NOT REQUIRED

F OCCUPANCY CERTIFICATE CONSTRUCTION BEGUN: _____ ACTUAL COST _____


COMPLETED: _____

CERTIFICATE APPROVED DENIED Reasons for denial are given in writing according to Law, a copy of which is appended hereto.

ZONING ADMINISTRATOR _____ DATE _____

H Check box(es) best describing proposed use or construction.

	Total	New	Cons.
		Addition	Alteration
SINGLE FAMILY	1	<input type="checkbox"/>	<input checked="" type="checkbox"/>
FAMILY	2	<input type="checkbox"/>	<input type="checkbox"/>
RETAIL	3	<input type="checkbox"/>	<input type="checkbox"/>
OFFICE	4	<input type="checkbox"/>	<input type="checkbox"/>
INDUSTRIAL	5	<input type="checkbox"/>	<input type="checkbox"/>
GARAGE (ATT.)	6	<input type="checkbox"/>	<input type="checkbox"/>
(DET.)	7	<input type="checkbox"/>	<input type="checkbox"/>
PORCH (OPEN)	8	<input type="checkbox"/>	<input type="checkbox"/>
(SCREENED)	9	<input type="checkbox"/>	<input type="checkbox"/>
(ENCLOSED)	10	<input type="checkbox"/>	<input type="checkbox"/>
(DECK)	11	<input type="checkbox"/>	<input checked="" type="checkbox"/>
POOL (INGROUND)	12	<input type="checkbox"/>	<input type="checkbox"/>
(ABOVE GROUND)	13	<input type="checkbox"/>	<input type="checkbox"/>
SHED	14	<input type="checkbox"/>	<input type="checkbox"/>
BARN (AGRICULTURAL)	15	<input type="checkbox"/>	<input type="checkbox"/>
(RESIDENTIAL)	16	<input type="checkbox"/>	<input type="checkbox"/>
MOBILE HOME	17	<input type="checkbox"/>	<input type="checkbox"/>
VACATION	18	<input type="checkbox"/>	<input type="checkbox"/>
CONDOMINIUM	19	<input type="checkbox"/>	<input type="checkbox"/>
MISCELLANEOUS	20	<input type="checkbox"/>	<input type="checkbox"/>
RENEWAL	21	<input type="checkbox"/>	<input type="checkbox"/>

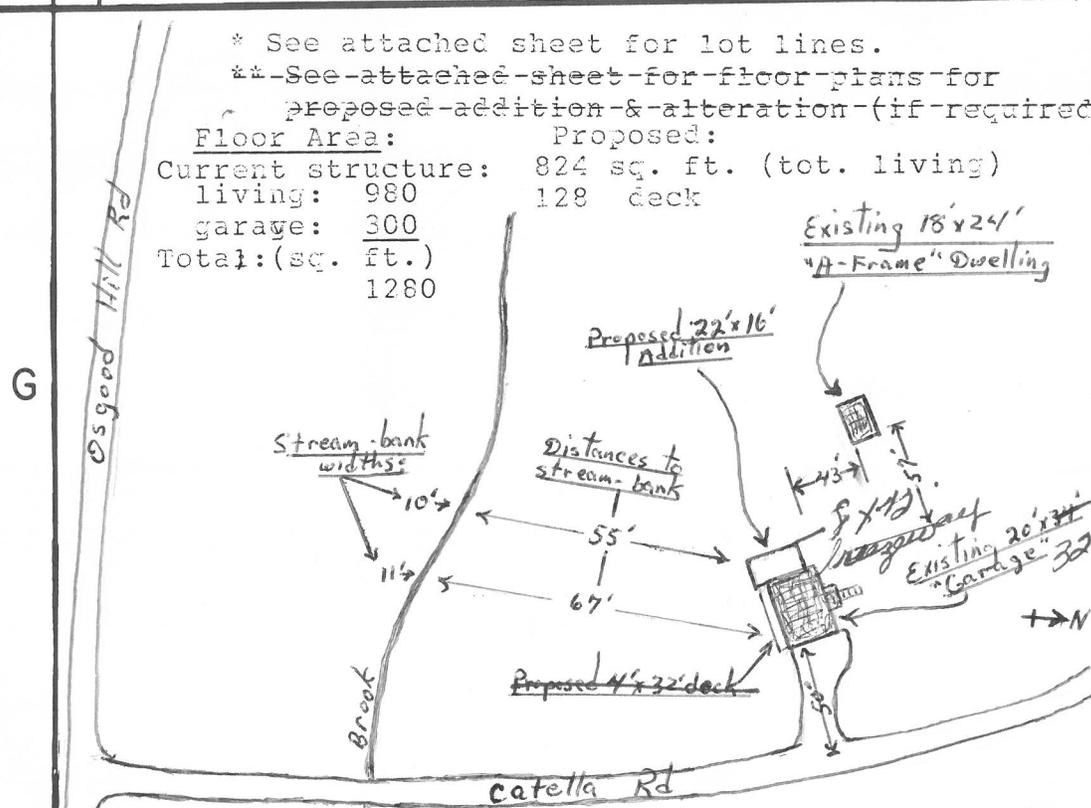

I SIGNATURE OF OWNER
Mark R Hunziker

J FOR OFFICE USE ONLY
FEE PAID 120.00
APPROVED REJECTED
ISSUED TO M. Hunziker
DATE Oct. 23, 1990
J. Z. [Signature]
Zoning Administrator

ZONING BOARD OF ADJUSTMENT
APPROVED REJECTED
DATE _____
PLANNING COMMISSION
APPROVED REJECTED
DATE _____

THIS PERMIT VALID FOR TWELVE MONTHS ONLY FROM ISSUE
APPROVAL IS SUBJECT TO THE ACCURACY OF INFORMATION GIVEN BY APPLICANT
The "A-Frame Dwelling" will be abandoned prior to occupancy of the new dwelling.